


MAP

SCHL

FIGURE 1

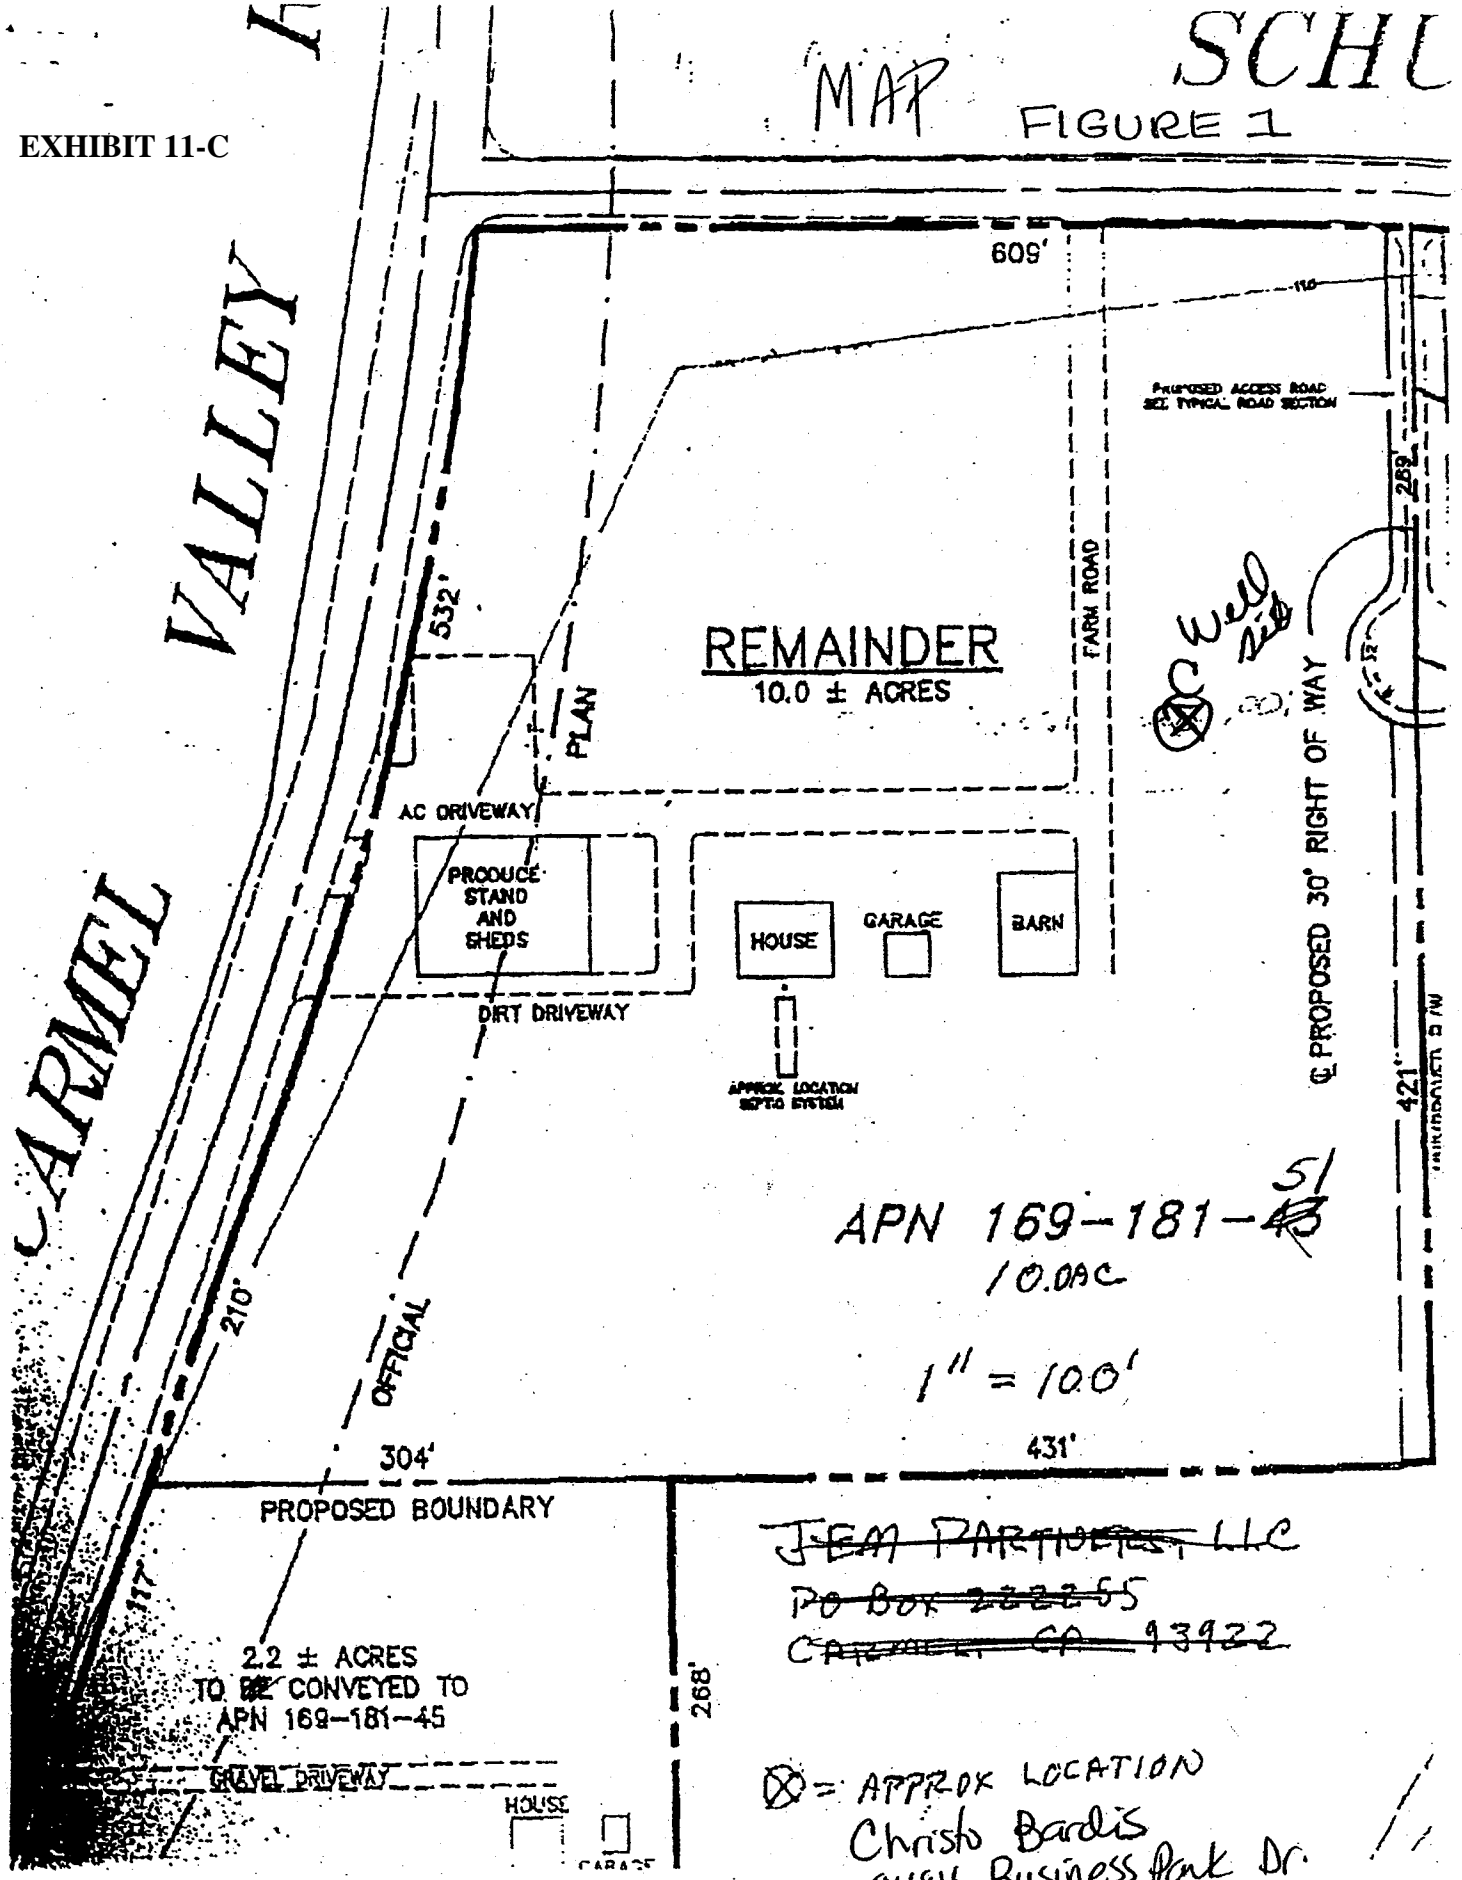

REMAINDER
10.0 ± ACRES

PRODUCE
STAND
AND
SHEDS

HOUSE

GARAGE

BARN

APN 169-181-51
10.0AC

1" = 100'

~~JEAN PARTIERS LLC~~
~~PO BOX 222255~~
~~CARMEL, CA 93922~~

2.2 ± ACRES
TO BE CONVEYED TO
APN 169-181-45

⊗ = APPROX LOCATION
Christo Bardis
9484 Business Park Dr.
Ste H
Sacramento, CA 95827