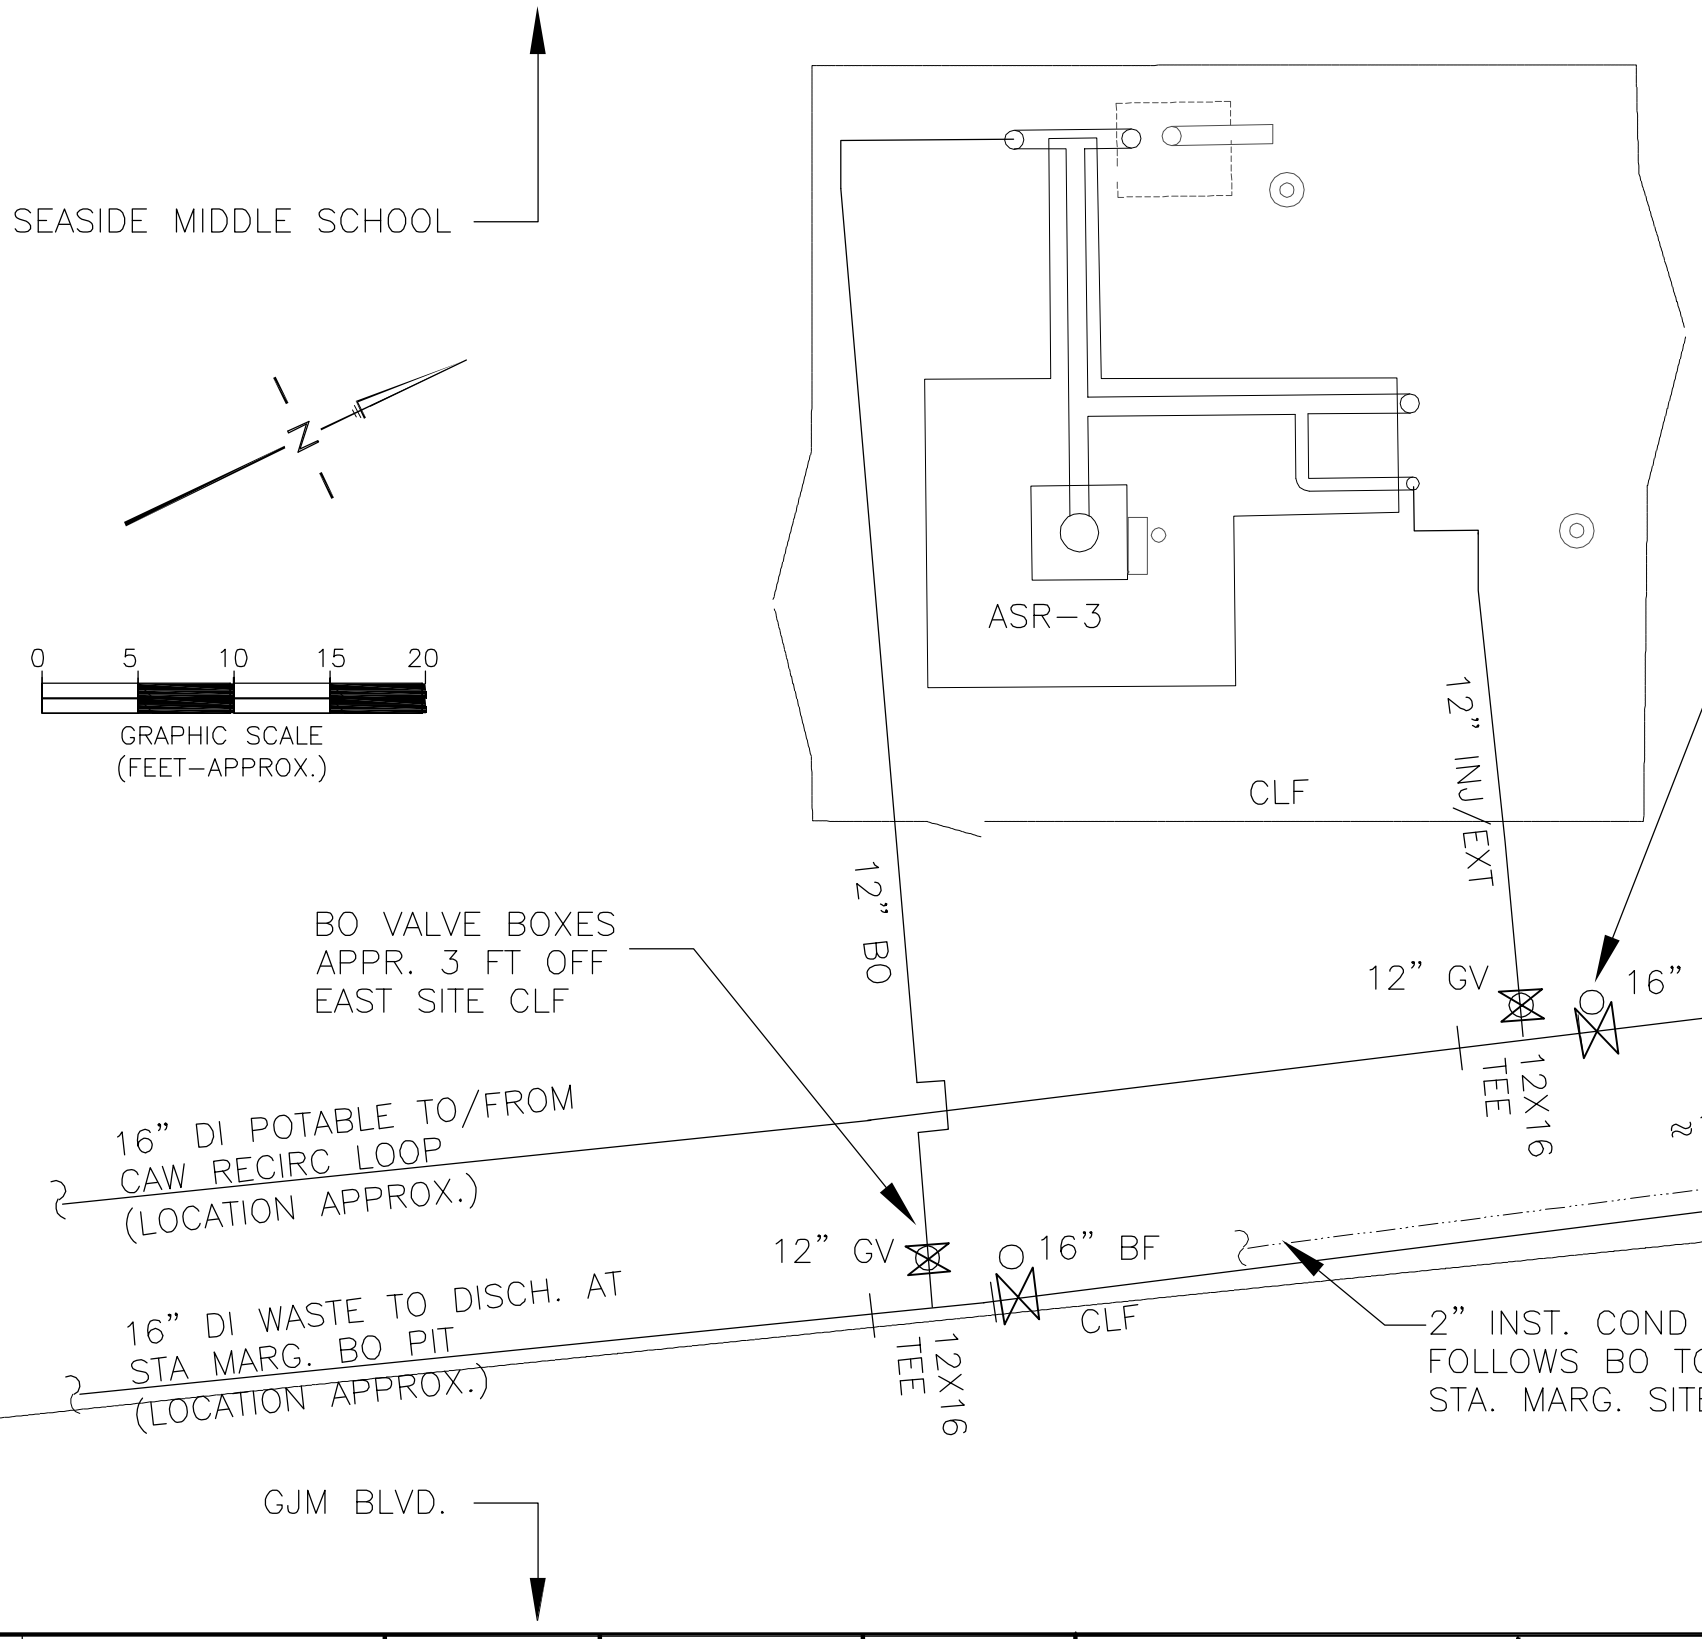

DRAWING NOTES:

1. INSTALLED PIPING SHOWN SHOWN SCHEMATICALLY ONLY.
2. ASR–4 PIPING IS SHOWN IN APPROXIMATE LOCATION RELATIVE TO EXISTING FACILITIES, BASED ON INTERMITTENT OBSERVATION AND FIELD MEASUREMENTS TAKEN WITH A HANDHELD TAPE MEASURE DURING CONSTRUCTION, OR ON AVAILABLE RECORD DRAWING DETAILS.
3. BASEMAP DETAIL PROVIDED BY CENTRAL COAST SURVEYORS, BASED ON TOPOGRAPHIC SURVEY, AUGUST 2013. SOME DETAILS REMOVED FOR CLARITY.
4. LOCATION OF ASR–3 VALVES AND CONNECTING PIPING BELOW GRADE INFERRED BASED ON INSTALLATION DRAWINGS BY C+D ENGINEERS AND OTHER AVAILABLE RECORDS, AND OBSERVATION OF EXISTING ABOVE GRADE FEATURES. INSTALLATION NOT PART OF THIS PROJECT.
5. INTENT OF DRAWING IS TO SHOW CONFIGURATION AND APPROXIMATE LOCATION OF PIPING FOR PLANNING FUTURE MAINTENANCE OR CONSTRUCTION. EXACT LOCATION OF UNDERGROUND UTILITIES SHALL BE DETERMINED BY CONTRACTOR PRIOR TO ANY FUTURE EXCAVATION ACTIVITIES.
6. REFER TO CONSTRUCTION FIELD NOTES AND SKETCHES FOR ADDITIONAL FITTING DETAILS AT PIPING TIE–INS.

REV	DATE	BY	DESCRIPTION

SCALE: APPROXIMATE ONLY AS SHOWN

DESIGNED:
DRAWN: D. Norris
CHECKED:
DATE: 10-14-13

Norris Associates
Water and Wastewater Engineering
P.O. Box 125
Carmel Valley, CA 93924
www.nawwwengineering.com

MONTEREY PENINSULA WATER MANAGEMENT DISTRICT

ASR PROJECT 2013

PUEBLO WATER RESOURCES

SEASIDE MIDDLE SCHOOL SITE

ASR-3 BURIED VALVE LOCATIONS

RECORD DRAWING

SHEET NUMBER 2 OF 2 SHEETS

DRAWING NO. R-2