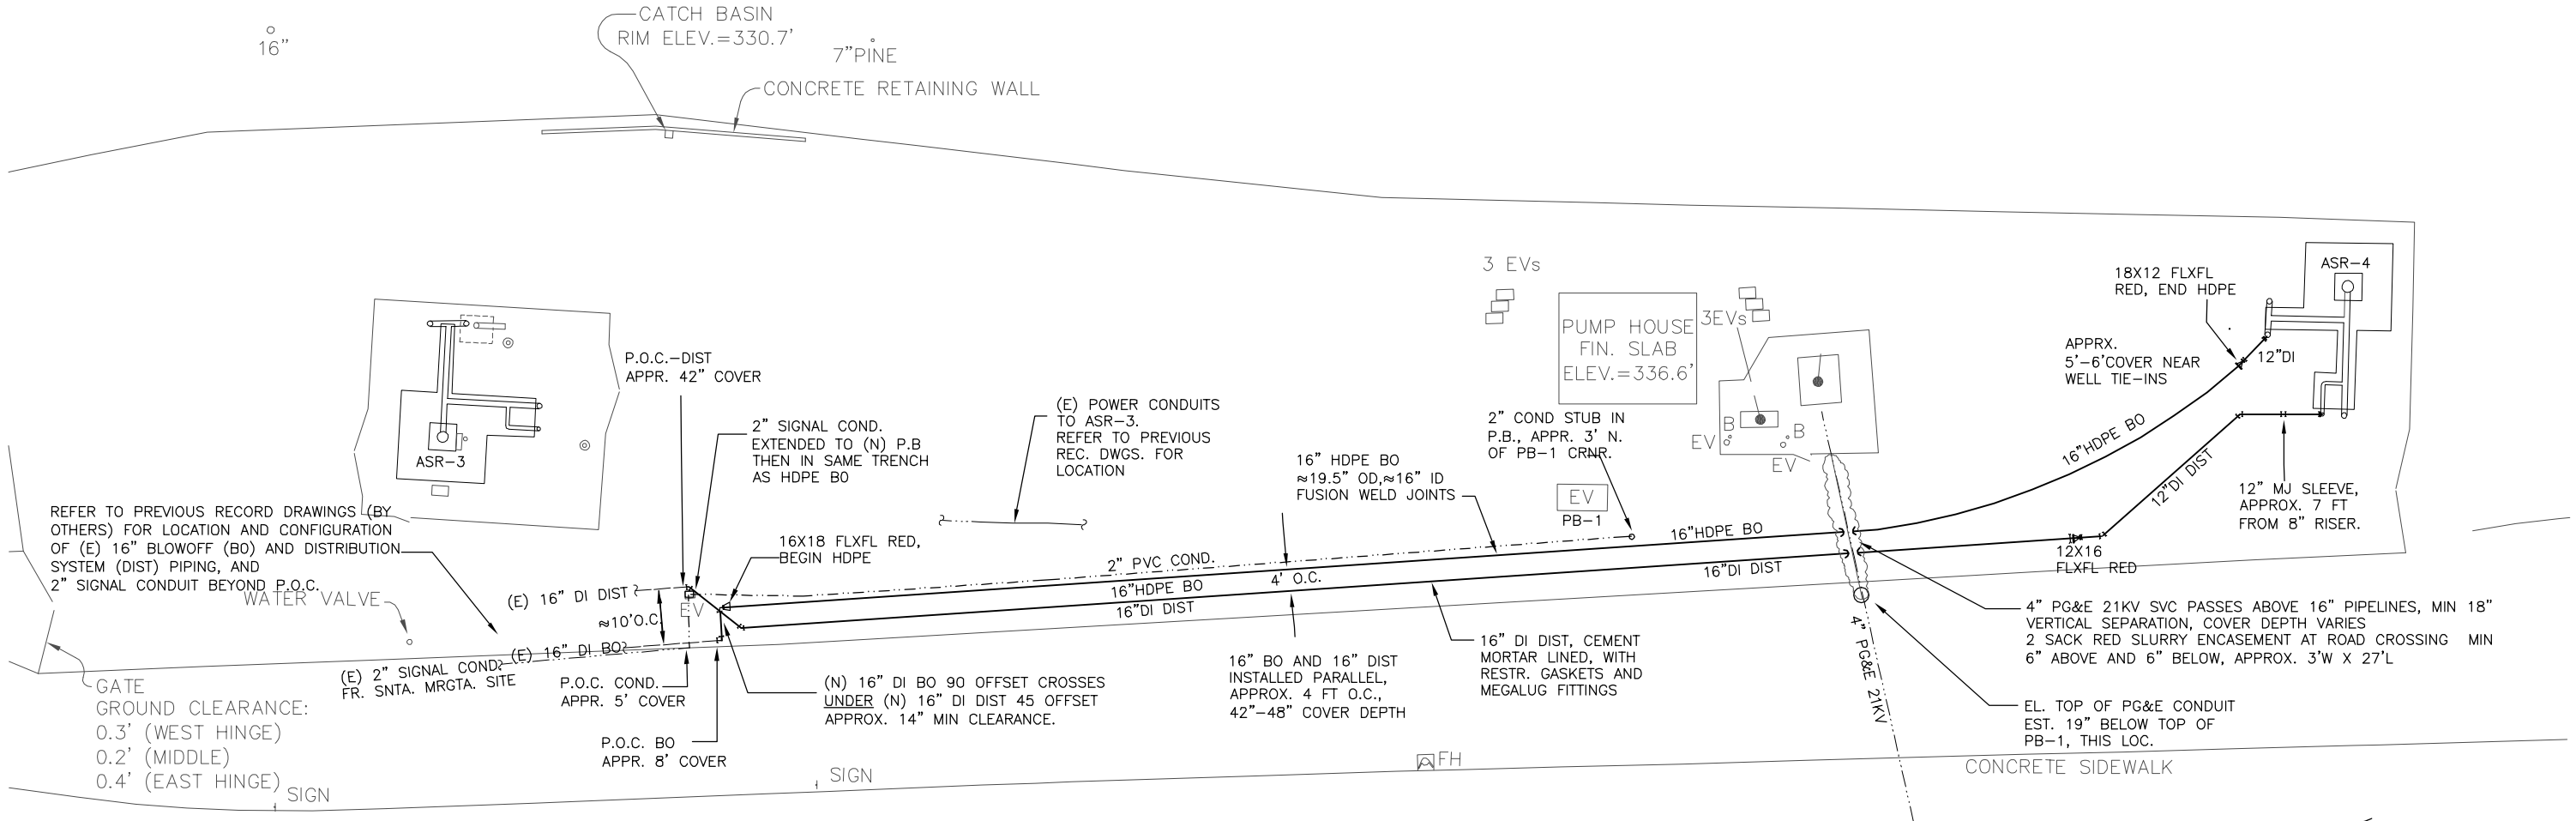

DRAWING NOTES:

1. INSTALLED PIPING SHOWN SHOWN SCHEMATICALLY ONLY.
2. PIPING SHOWN IN APPROXIMATE LOCATION RELATIVE TO EXISTING FACILITIES, BASED ON INTERMITTENT OBSERVATION AND FIELD MEASUREMENTS TAKEN WITH A HANDHELD TAPE MEASURE DURING CONSTRUCTION.
3. BASEMAP DETAIL PROVIDED BY CENTRAL COAST SURVEYORS, BASED ON TOPOGRAPHIC SURVEY, AUGUST 2013. SOME DETAILS REMOVED FOR CLARITY.
4. REFER TO PREVIOUS RECORD DRAWINGS FOR LOCATION OF EXISTING VALVES AND ELECTRICAL CONDUIT NOT AFFECTED ON THIS PROJECT.
5. INTENT OF DRAWING IS TO SHOW CONFIGURATION AND APPROXIMATE LOCATION OF PIPING FOR PLANNING FUTURE MAINTENANCE OR CONSTRUCTION. EXACT LOCATION OF UNDERGROUND UTILITIES SHALL BE DETERMINED BY CONTRACTOR PRIOR TO ANY FUTURE EXCAVATION ACTIVITIES.
6. REFER TO CONSTRUCTION FIELD NOTES AND SKETCHES FOR ADDITIONAL FITTING DETAILS AT PIPING TIE-INS.

0 10 20 30 40
GRAPHIC SCALE
(FEET)

N

REV	DATE	BY	DESCRIPTION

SCALE:
APPROXIMATE ONLY
AS SHOWN

DESIGNED:
DRAWN: D. Norris
CHECKED:
DATE: 9-26-13

Norris Associates
Water and Wastewater Engineering
P.O. Box 125
Carmel Valley, CA 93924
www.nawwwengineering.com

MONTEREY PENINSULA WATER MANAGEMENT DISTRICT

ASR PROJECT 2013

PUEBLO WATER RESOURCES

SEASIDE MIDDLE SCHOOL SITE

ASR-4 UNDERGROUND PIPING
INSTALLATION MAY-JUNE 2013

RECORD DRAWING

SHEET NUMBER
1
OF 1 SHEETS

DRAWING NO.
R-1